


Scale: Not To Scale

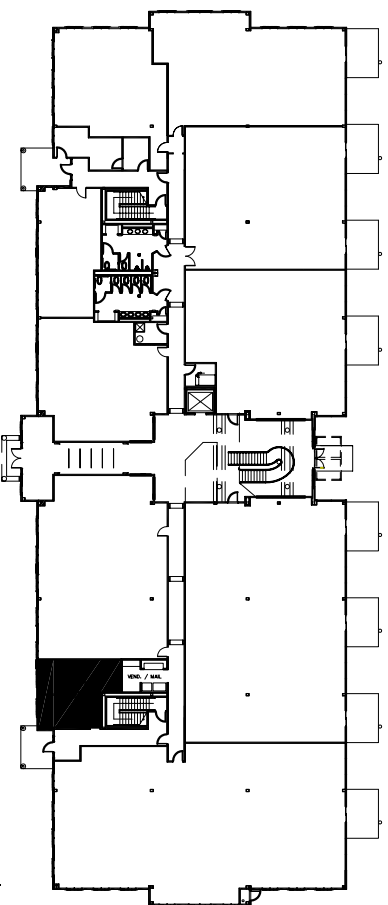

Key Plan

580 RSF

RUBICON
At Lanier Point

A BACKMAN, L.C. AFFILIATE
ONE BUCKHEAD PLAZA
3060 PEACHTREE ROAD
SUITE 210
ATLANTA, GEORGIA 30305
404.816.6400 P
404.816.3801 F



Rubicon at Lanier Point • Suite 106

As Built